

MIT
MEDIA
LABORATORY
EXPANSION


LEERS WEINZAPFEL ASSOCIATES
ARCHITECT OF RECORD
75 KNEELAND STREET
BOSTON, MA 02111
617-423-5711

MAKI AND ASSOCIATES
DESIGN ARCHITECT
13-4 HACHIYAMA CHO
SHIBUYA KU, TOKYO 150-0035
81-3-3780-3880

REVISIONS:	DATE
ITEM	
△ SKA-185	25 AUG. 2008
△ SKA-298	08 JAN. 2009
△ SKA-248.1	01 DEC. 2008
△ SKA-312	18 FEB. 2009
△ SKA-329 R1	3 APR. 2009
△ SKA-153	16 JUN. 2008
△ SKA-481	10 AUG. 2009
△ SKA-353	20 MAR. 2009

CHECKED BY: JP, GK

PROJECT #: 98152
CONSTRUCTION DOCUMENTS: NOVEMBER 15, 2006
RECORD DRAWINGS: MARCH 5, 2010


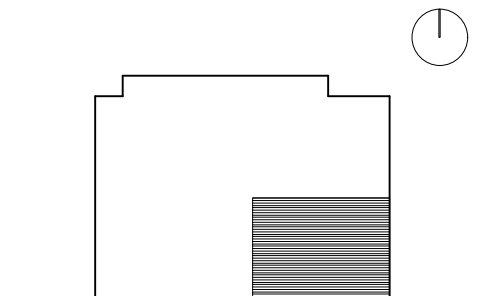


KEY

SCALE: 1/4"=1'-0"

EAST ENTRY
CEILING PLAN

A 5.105

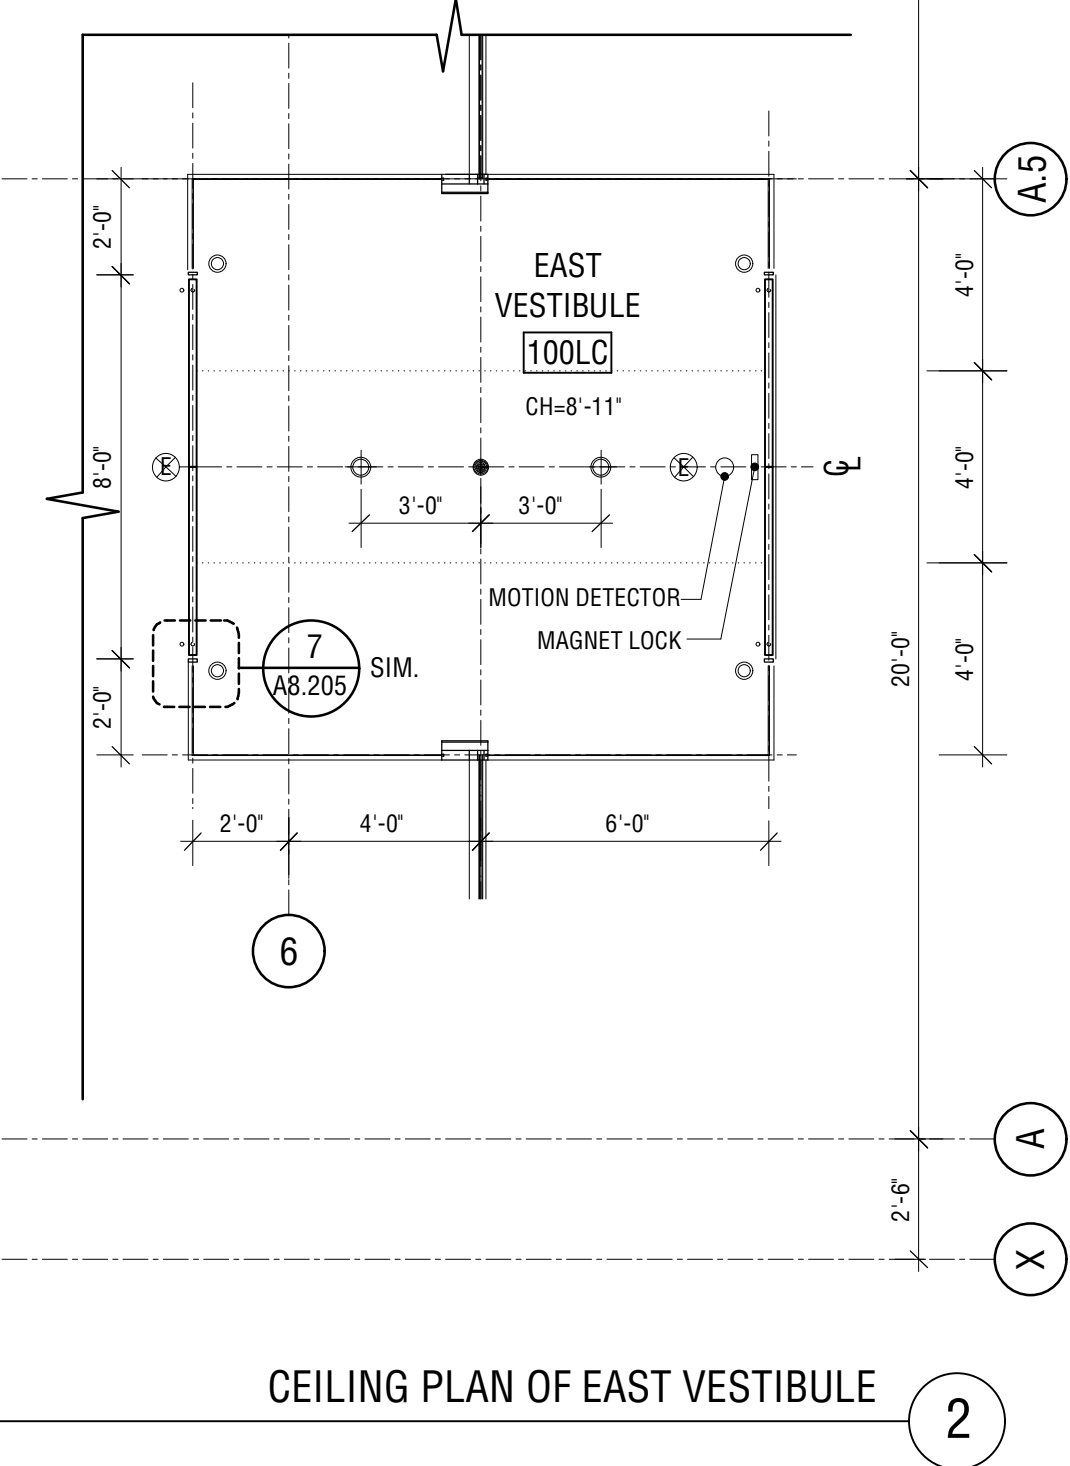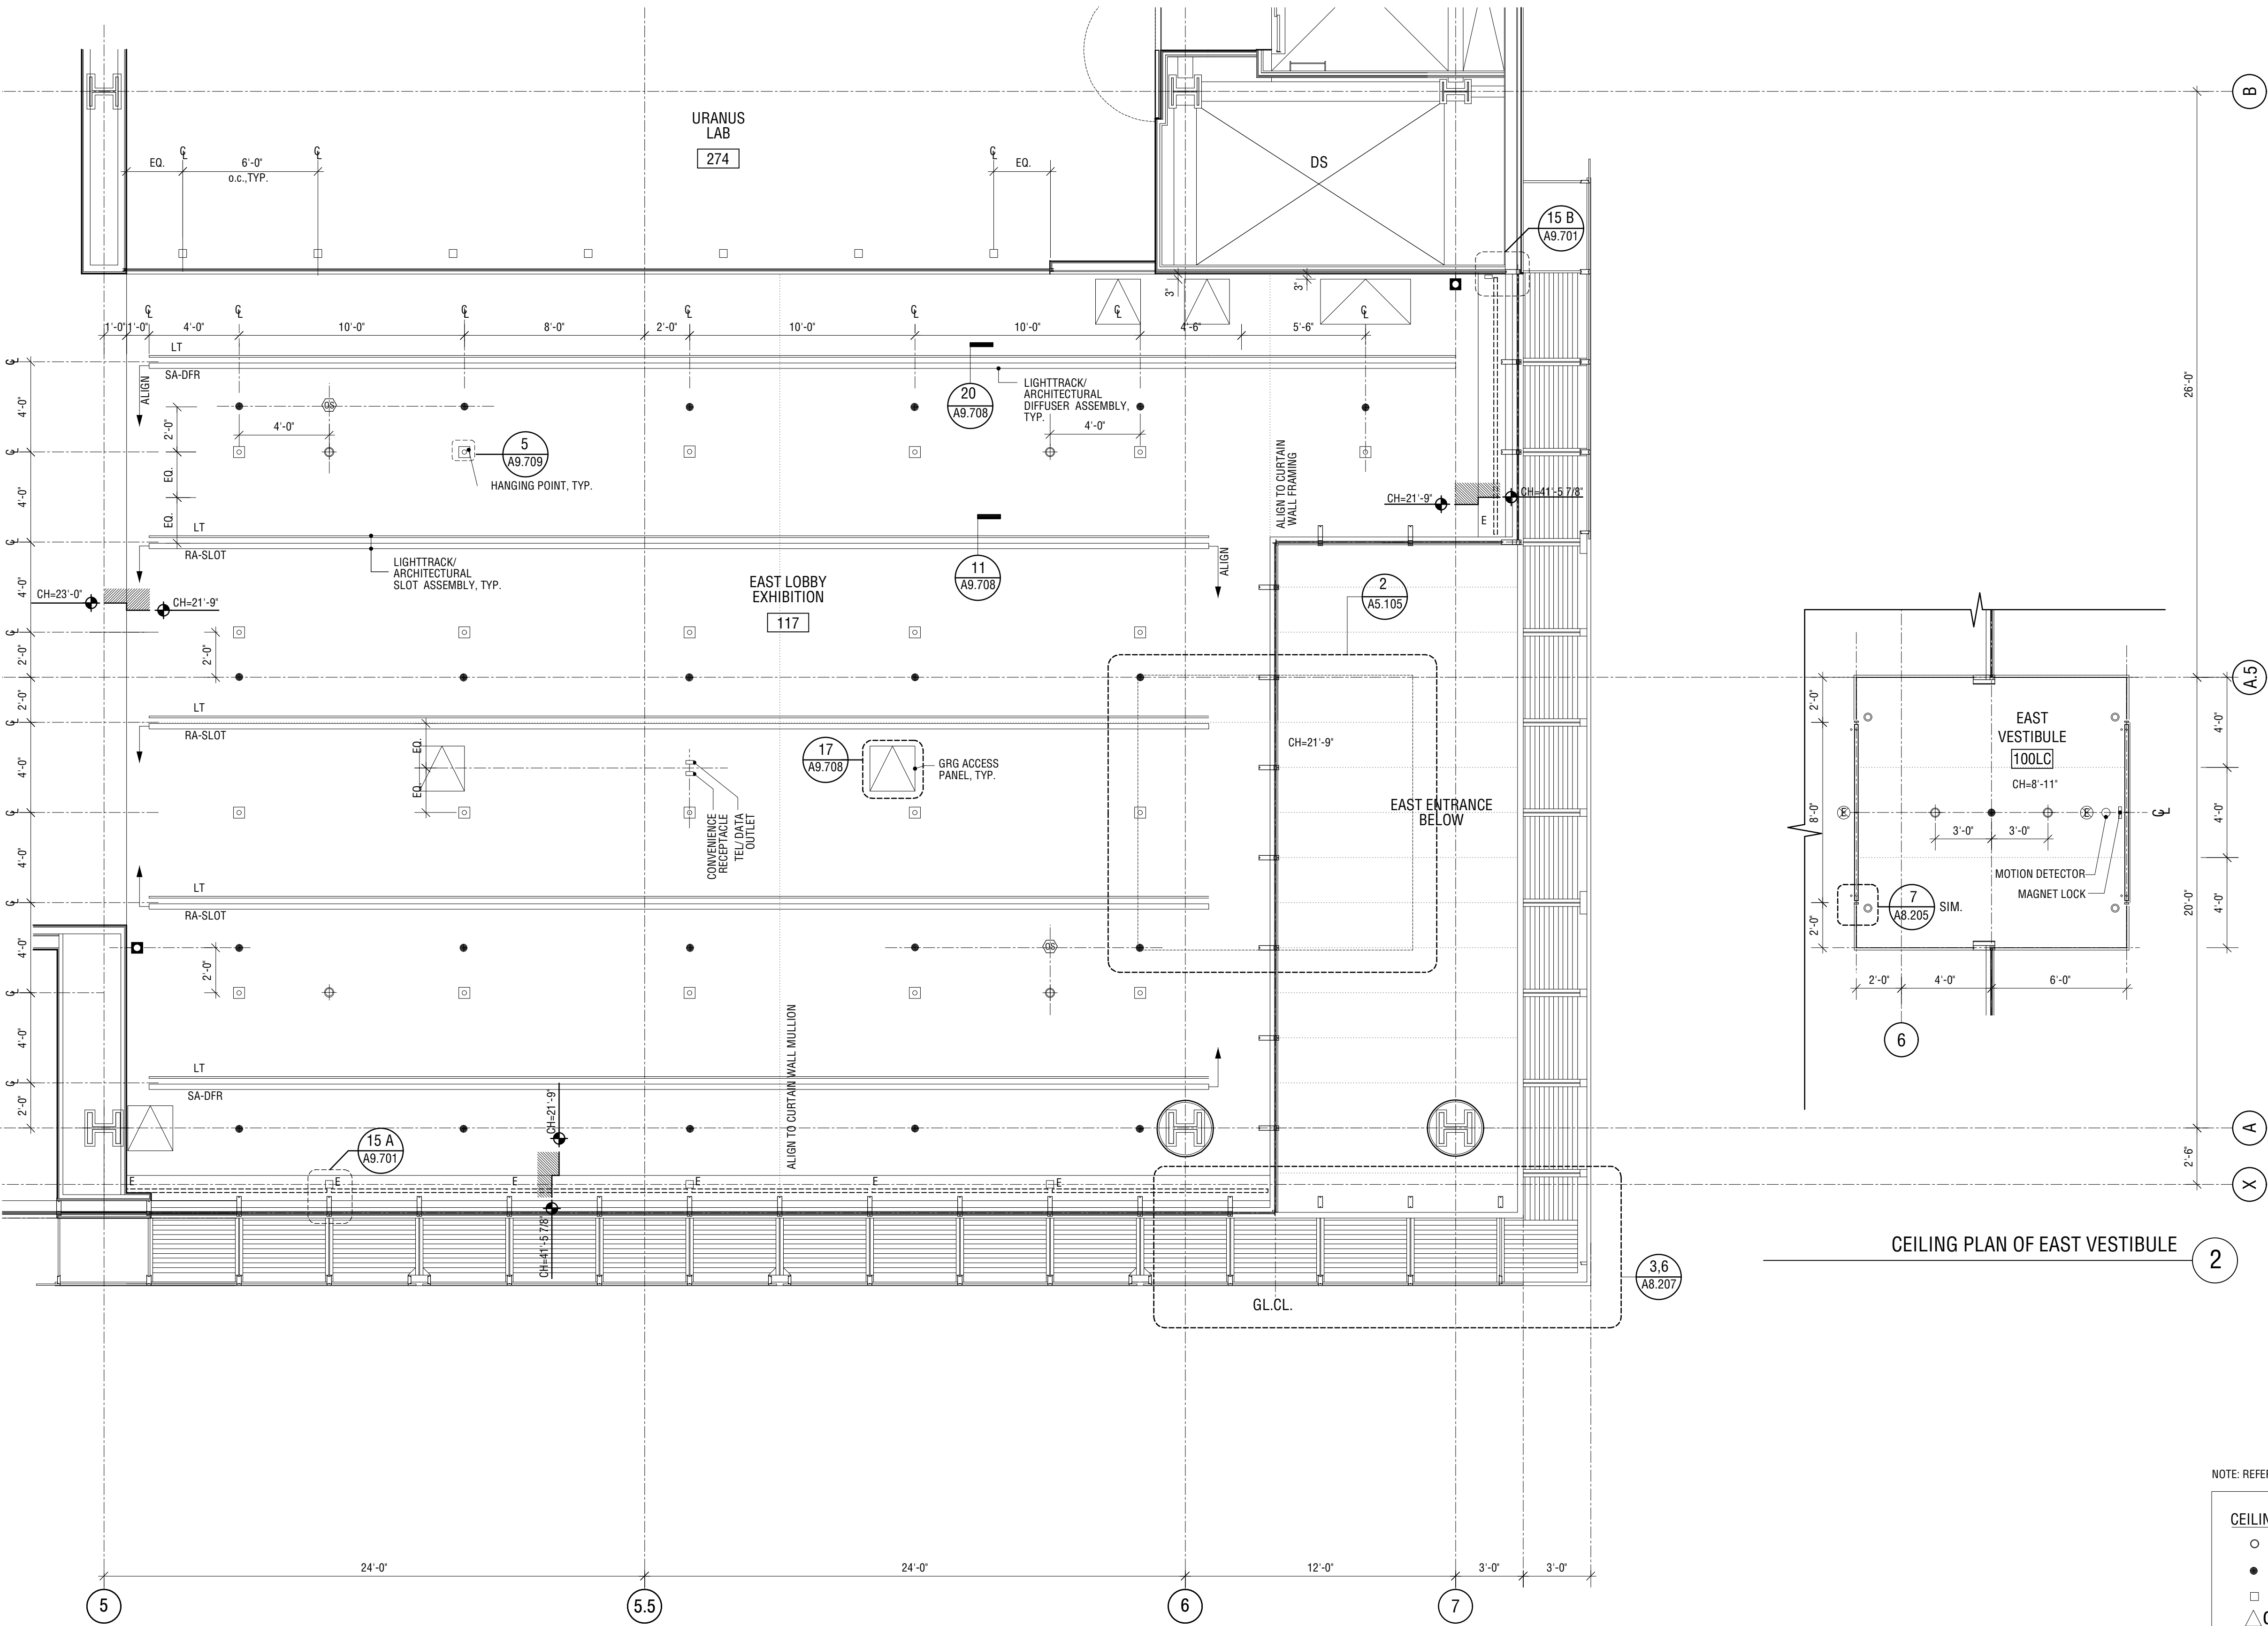

NOTE: REFER TO FINISHES SCHEDULE FOR FINISHES

CEILING PLAN SYMBOLS:

- UPRIGHT SPRINKLER HEAD
- FLUSH CONCEALED SPRINKLER HEAD
- WATER CURTAIN
- △ C FLUSH CONCEALED SIDE WALL SPRINKLER HEAD
- ⊕ RECESSED DOWN LIGHT
- PENDANT LIGHT
- HANGING POINT
- ⊗ SUPPLY AIR DIFFUSER
- ⊘ RETURN AIR DIFFUSER
- ⊕ EXIT SIGNS
- ⊕ EXIT SIGNS WALL MOUNTED
- ⊕ SMOKE DETECTORS
- ⊕ SMOKE DETECTORS WALL MOUNTED
- POWER POINT
- LT LIGHTING TRACK
- ⊗ ACCESS PANEL
- ⊕ OCCUPANCY SENSOR
- E ELECTRICAL SHADE

CEILING PLAN

1

PARTIAL CEILING PLAN AT 9'-9" A.F.F

3